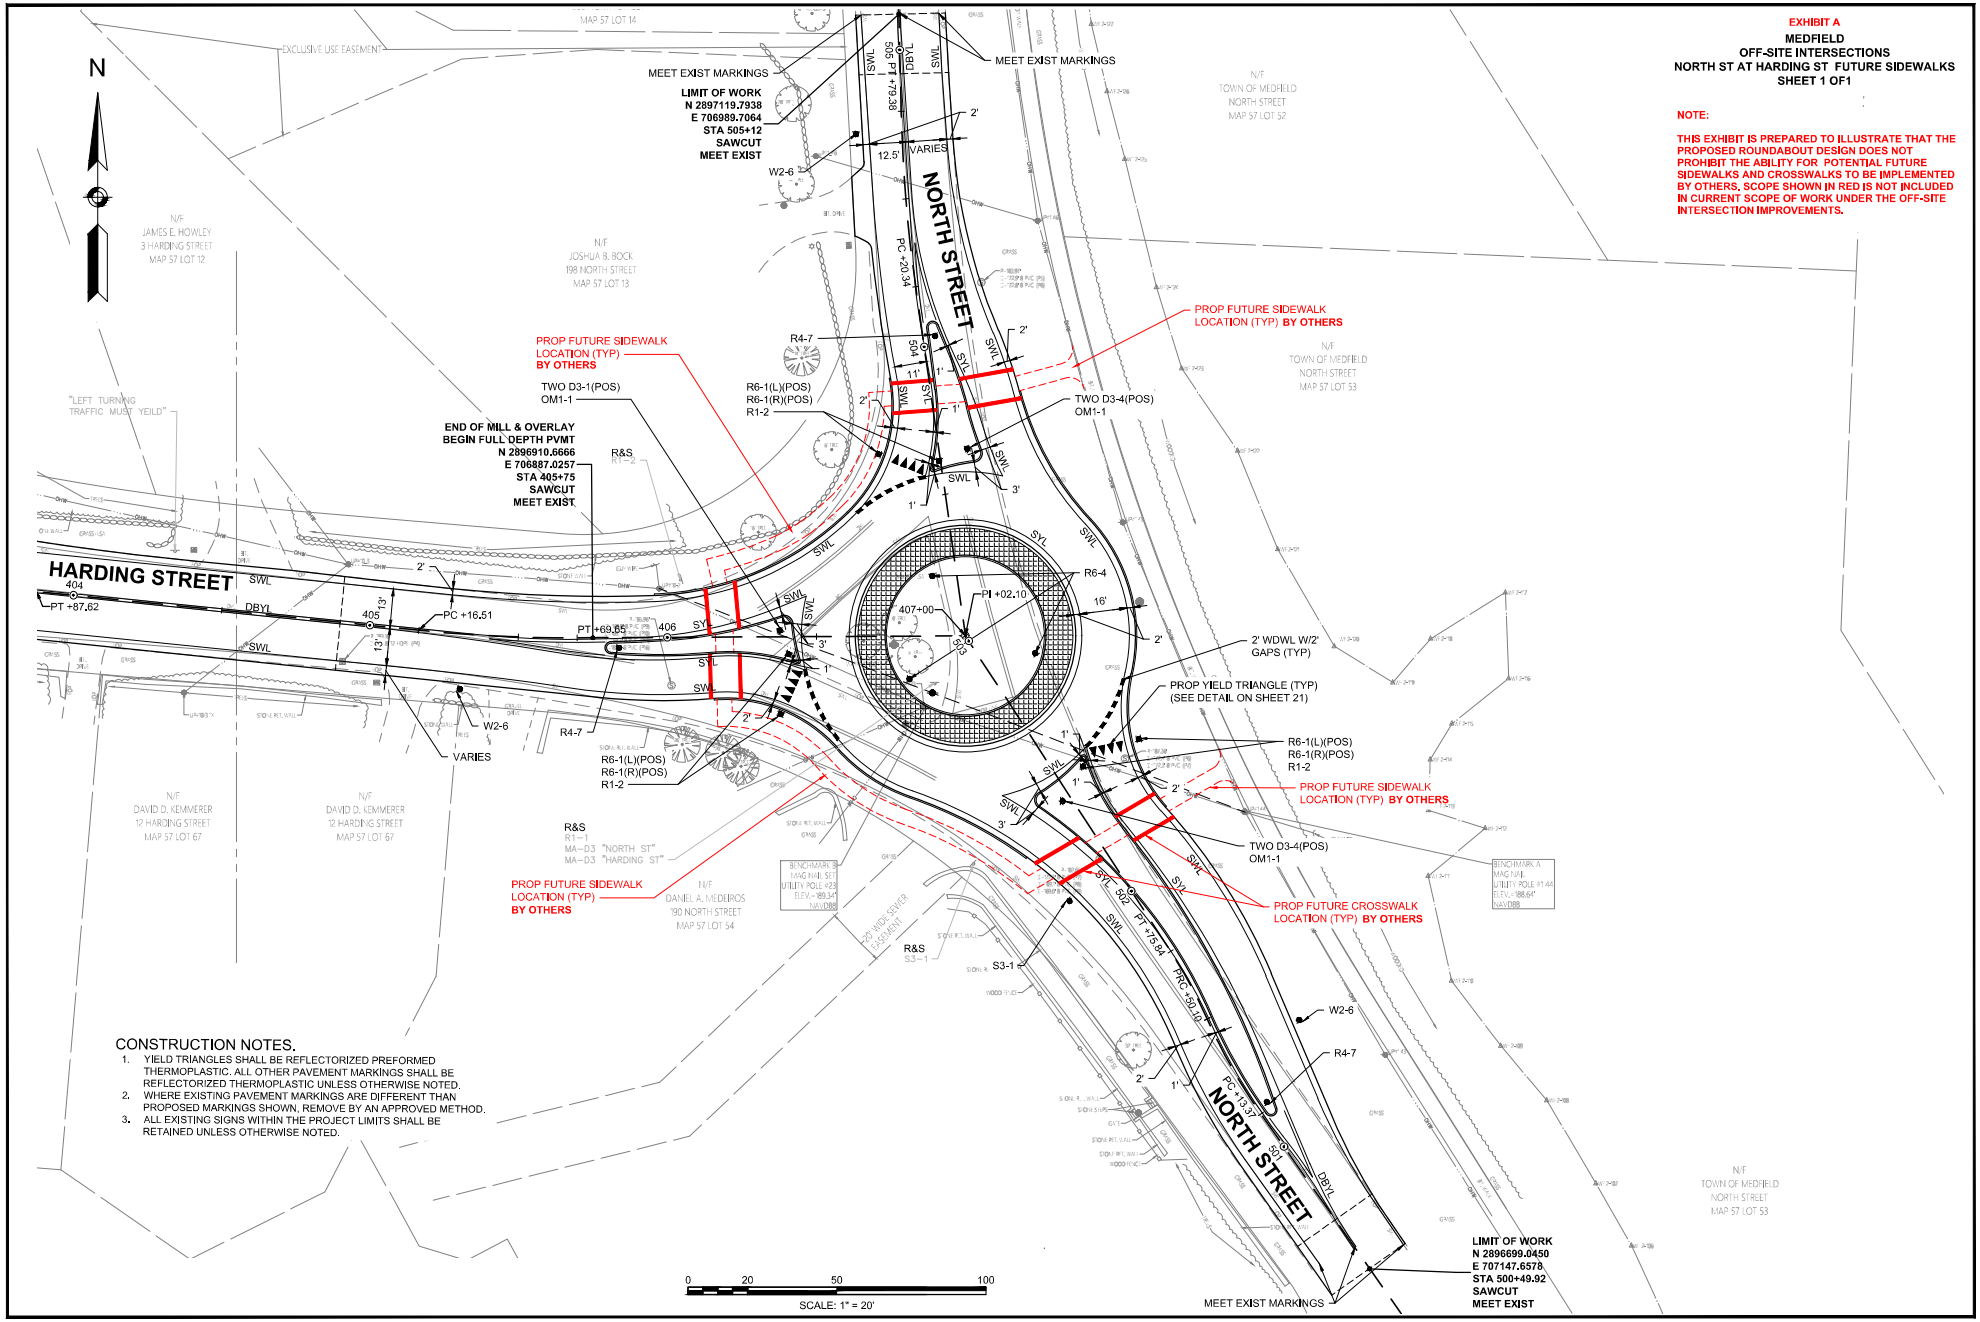

EXHIBIT A
MEDFIELD
OFF-SITE INTERSECTIONS
NORTH ST AT HARDING ST FUTURE SIDEWALKS
SHEET 1 OF1
NOTE:
THIS EXHIBIT IS PREPARED TO ILLUSTRATE THAT THE PROPOSED ROUNDABOUT DESIGN DOES NOT PROHIBIT THE ABILITY FOR POTENTIAL FUTURE SIDEWALKS AND CROSSWALKS TO BE IMPLEMENTED BY OTHERS. SCOPE SHOWN IN RED IS NOT INCLUDED IN CURRENT SCOPE OF WORK UNDER THE OFF-SITE INTERSECTION IMPROVEMENTS.
N
NORTH STREET
HARDING STREET
MEET EXIST MARKINGS
LIMIT OF WORK
N 2897119.7938
E 706989.7064
STA 505+12
SAWCUT
MEET EXIST
PROP FUTURE SIDEWALK LOCATION (TYP) BY OTHERS
END OF MILL & OVERLAY
BEGIN FULL DEPTH PVMT
N 2896910.6666
E 706887.0257
STA 405+75
SAWCUT
MEET EXIST
TWO D3-1(POS)
OM1-1
R6-1(L)(POS)
R6-1(R)(POS)
R1-2
R4-7
W2-6
VARIES
R&S
R1-2
R6-4
2' WDWL W/2' GAPS (TYP)
PROP YIELD TRIANGLE (TYP)
(SEE DETAIL ON SHEET 21)
TWO D3-4(POS)
OM1-1
PROP FUTURE CROSSWALK LOCATION (TYP) BY OTHERS
S3-1
LIMIT OF WORK
N 2896699.0450
E 707147.6578
STA 500+49.92
SAWCUT
MEET EXIST
"LEFT TURNING TRAFFIC MUST YEILD"
EXCLUSIVE USE EASEMENT
MAP 57 LOT 14
N/F JAMES E. HOWLEY 3 HARDING STREET MAP 57 LOT 12
N/F JOSHUA B. BOCK 198 NORTH STREET MAP 57 LOT 13
N/F TOWN OF MEDFIELD NORTH STREET MAP 57 LOT 52
N/F TOWN OF MEDFIELD NORTH STREET MAP 57 LOT 53
N/F DAVID D. KEMMERER 12 HARDING STREET MAP 57 LOT 67
N/F DANIEL A. MEDEIROS 190 NORTH STREET MAP 57 LOT 54
BENCHMARK B MAG NAIL SET UTILITY POLE #23 ELEV.=189.34 NAVD88
BENCHMARK A MAG NAIL UTILITY POLE #146 ELEV.=186.64 NAVD88
CONSTRUCTION NOTES.
1. YIELD TRIANGLES SHALL BE REFLECTORIZED PREFORMED THERMOPLASTIC. ALL OTHER PAVEMENT MARKINGS SHALL BE REFLECTORIZED THERMOPLASTIC UNLESS OTHERWISE NOTED.
2. WHERE EXISTING PAVEMENT MARKINGS ARE DIFFERENT THAN PROPOSED MARKINGS SHOWN, REMOVE BY AN APPROVED METHOD.
3. ALL EXISTING SIGNS WITHIN THE PROJECT LIMITS SHALL BE RETAINED UNLESS OTHERWISE NOTED.
0 20 50 100
SCALE: 1" = 20'
15677.00-STRP_FUTURE SIDEWALKS.DWG Plotted on 31-Mar-2025 - 11:09 AM